




GRUNDRISS 10.OG

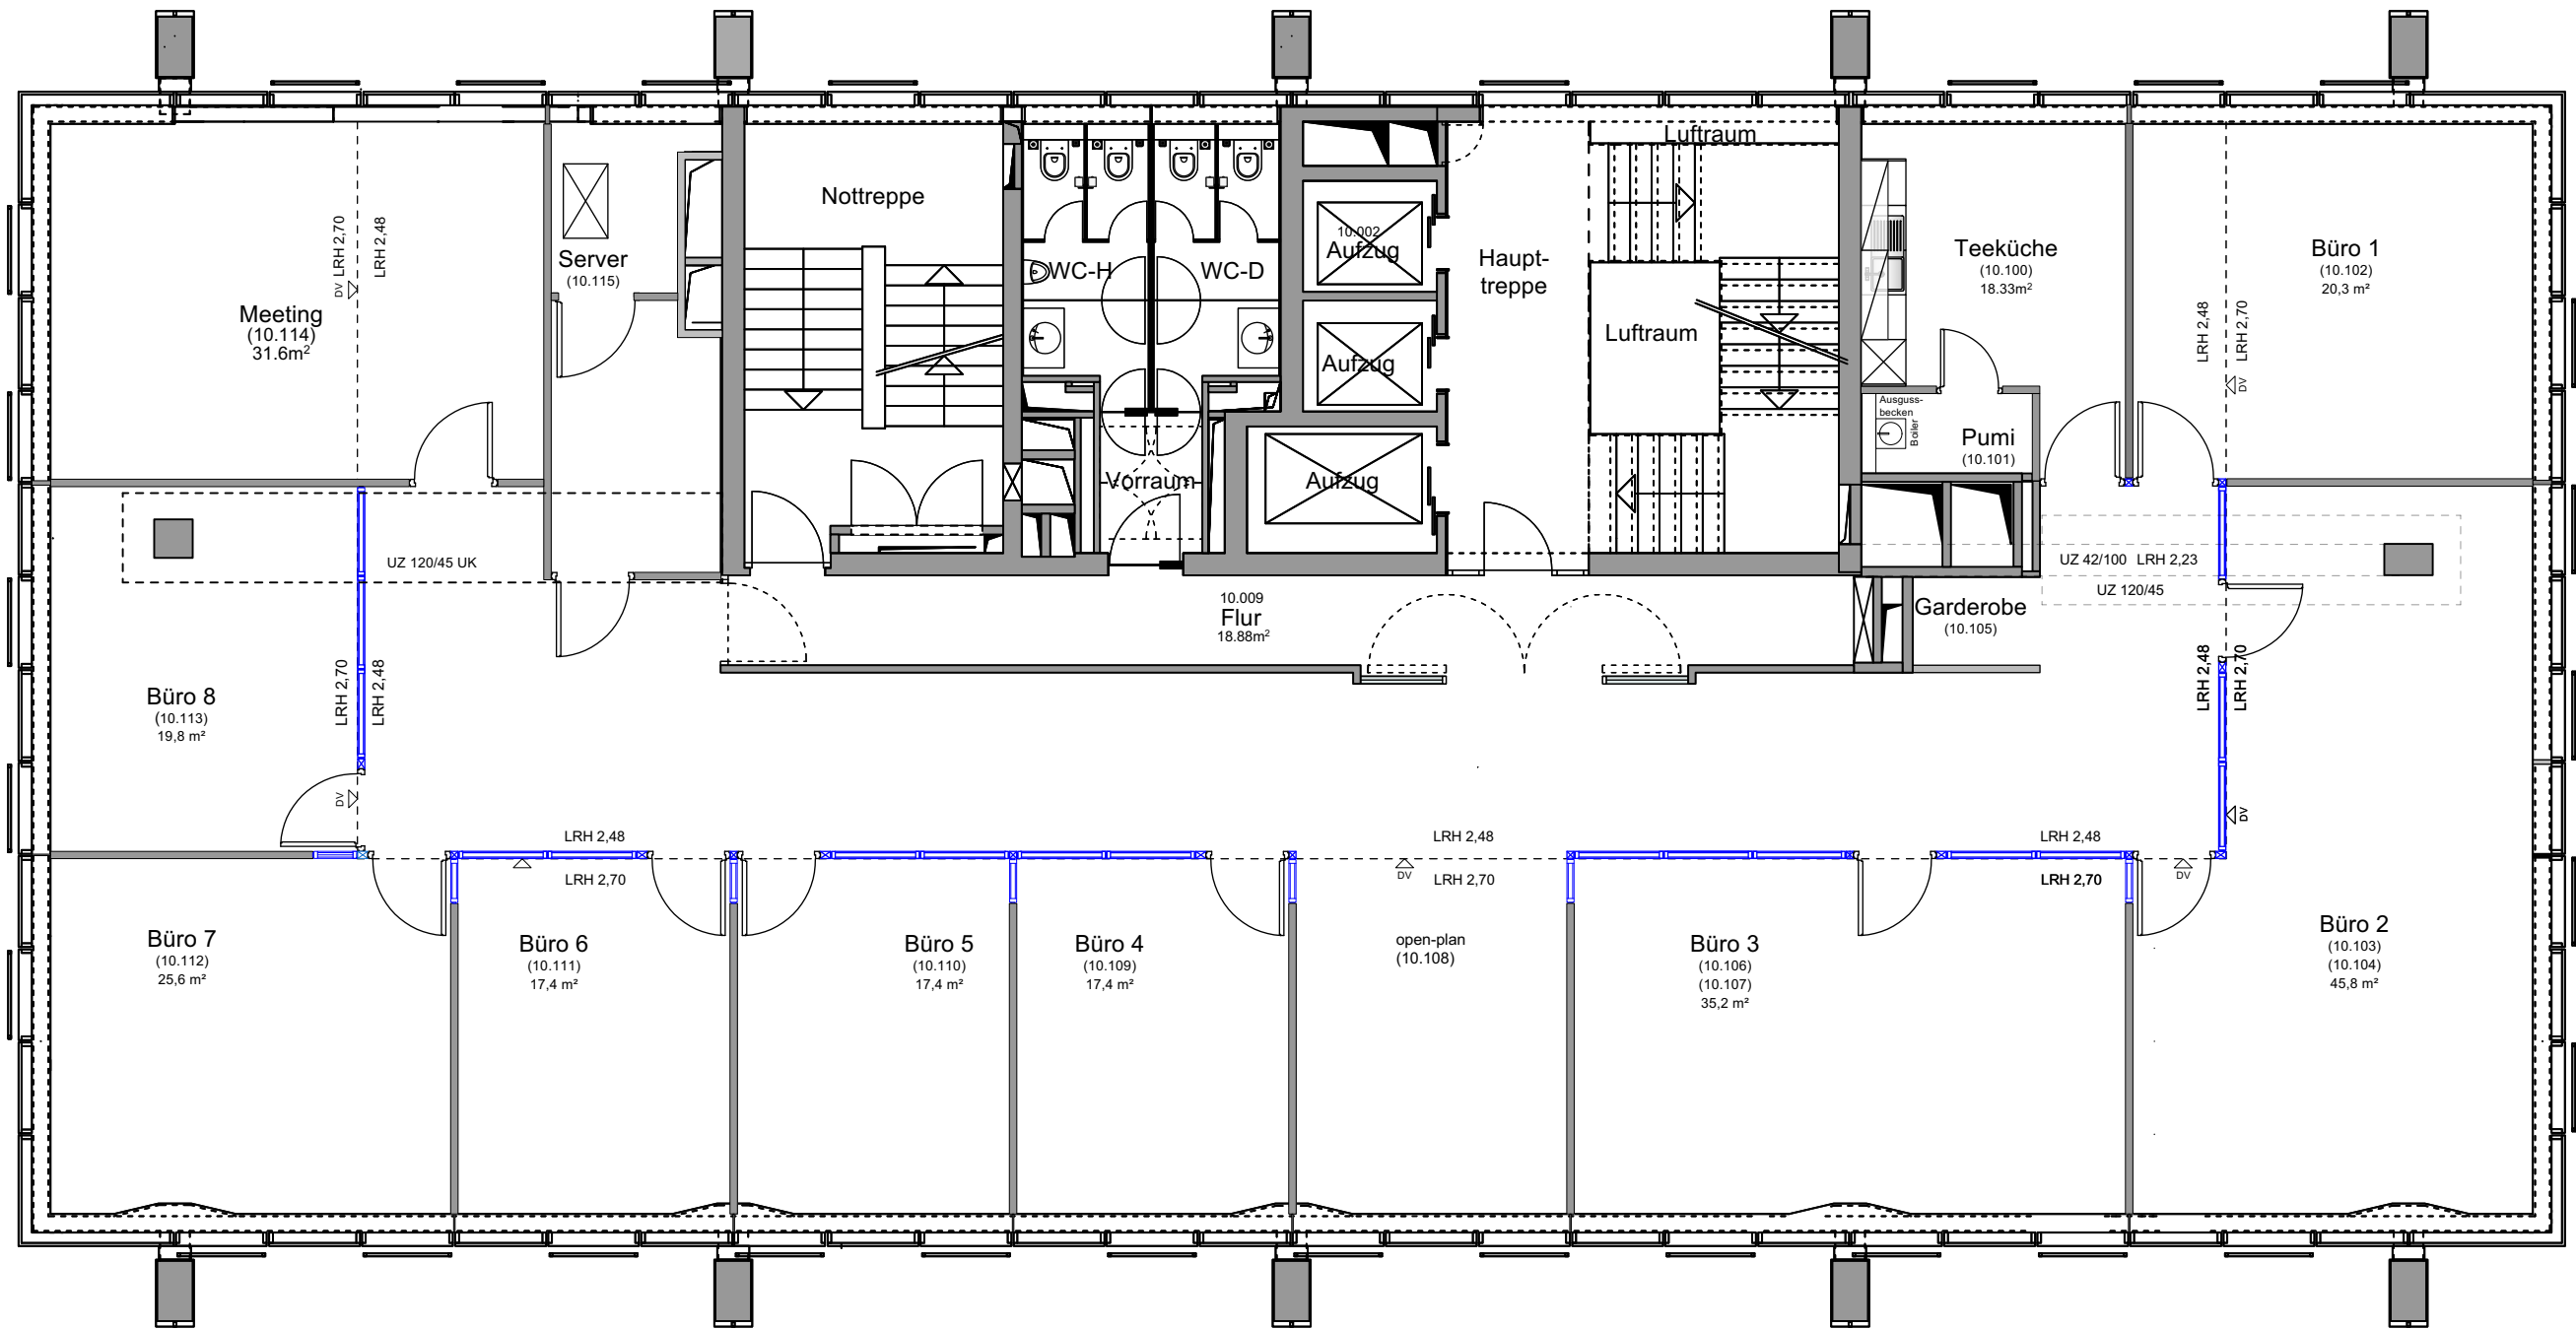


GRUNDRISS 11.OG

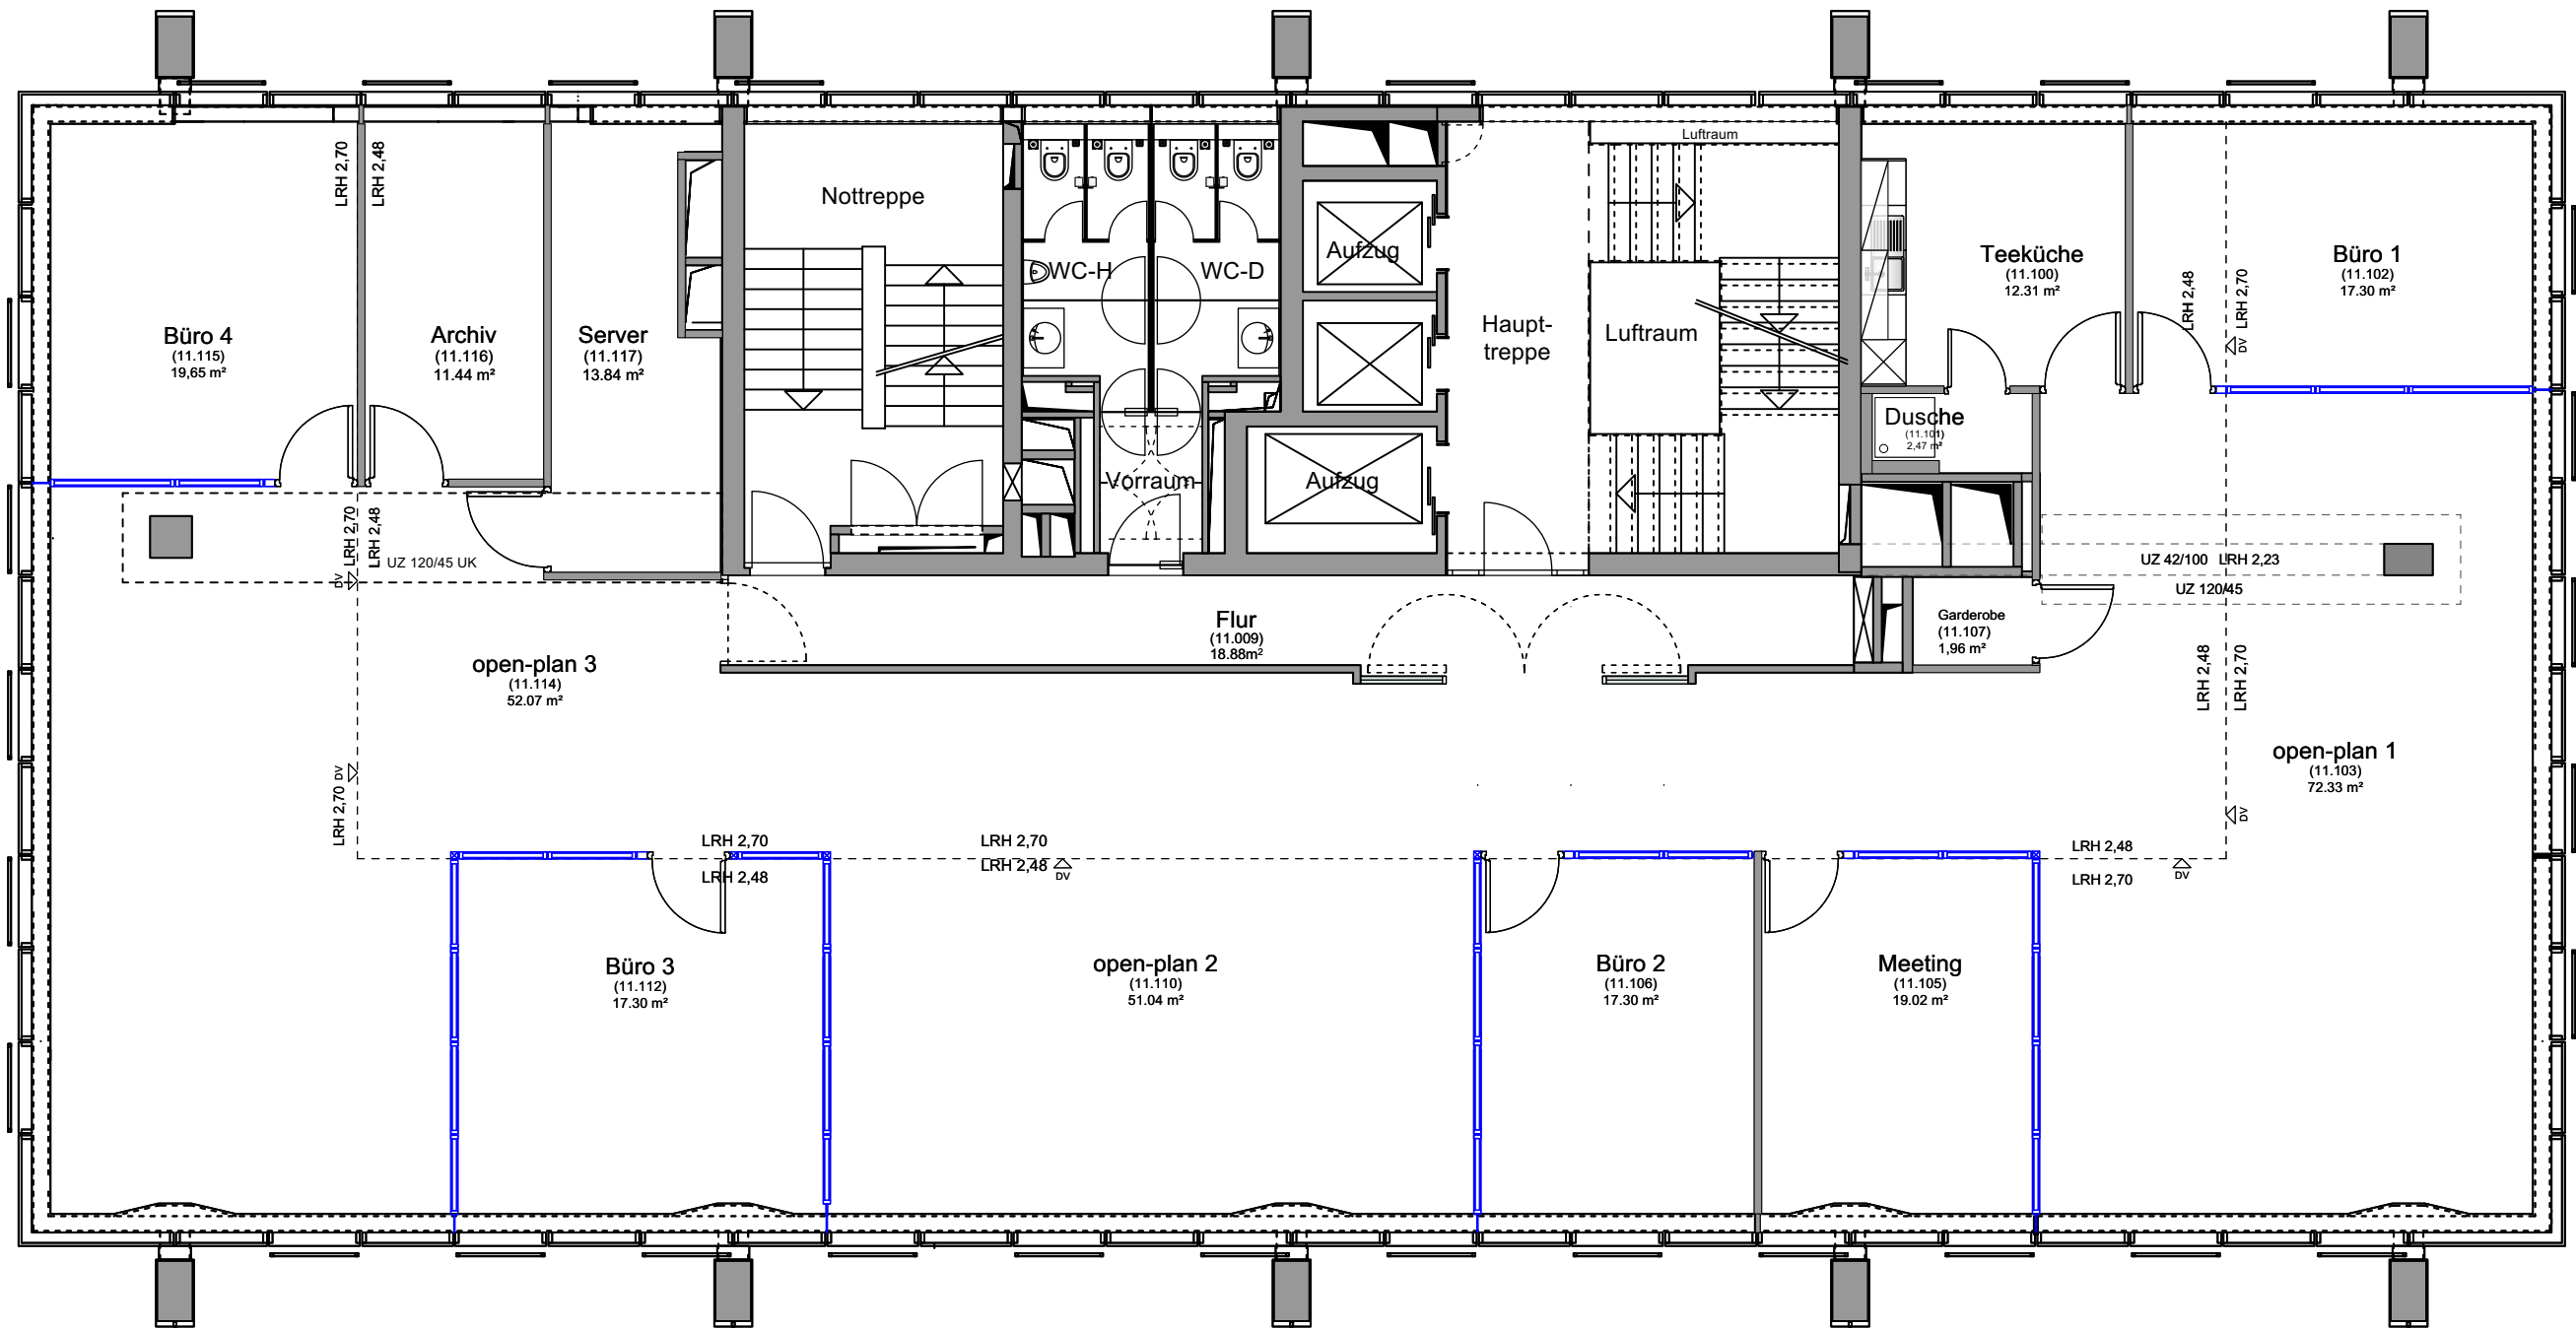


GRUNDRISS 12.OG

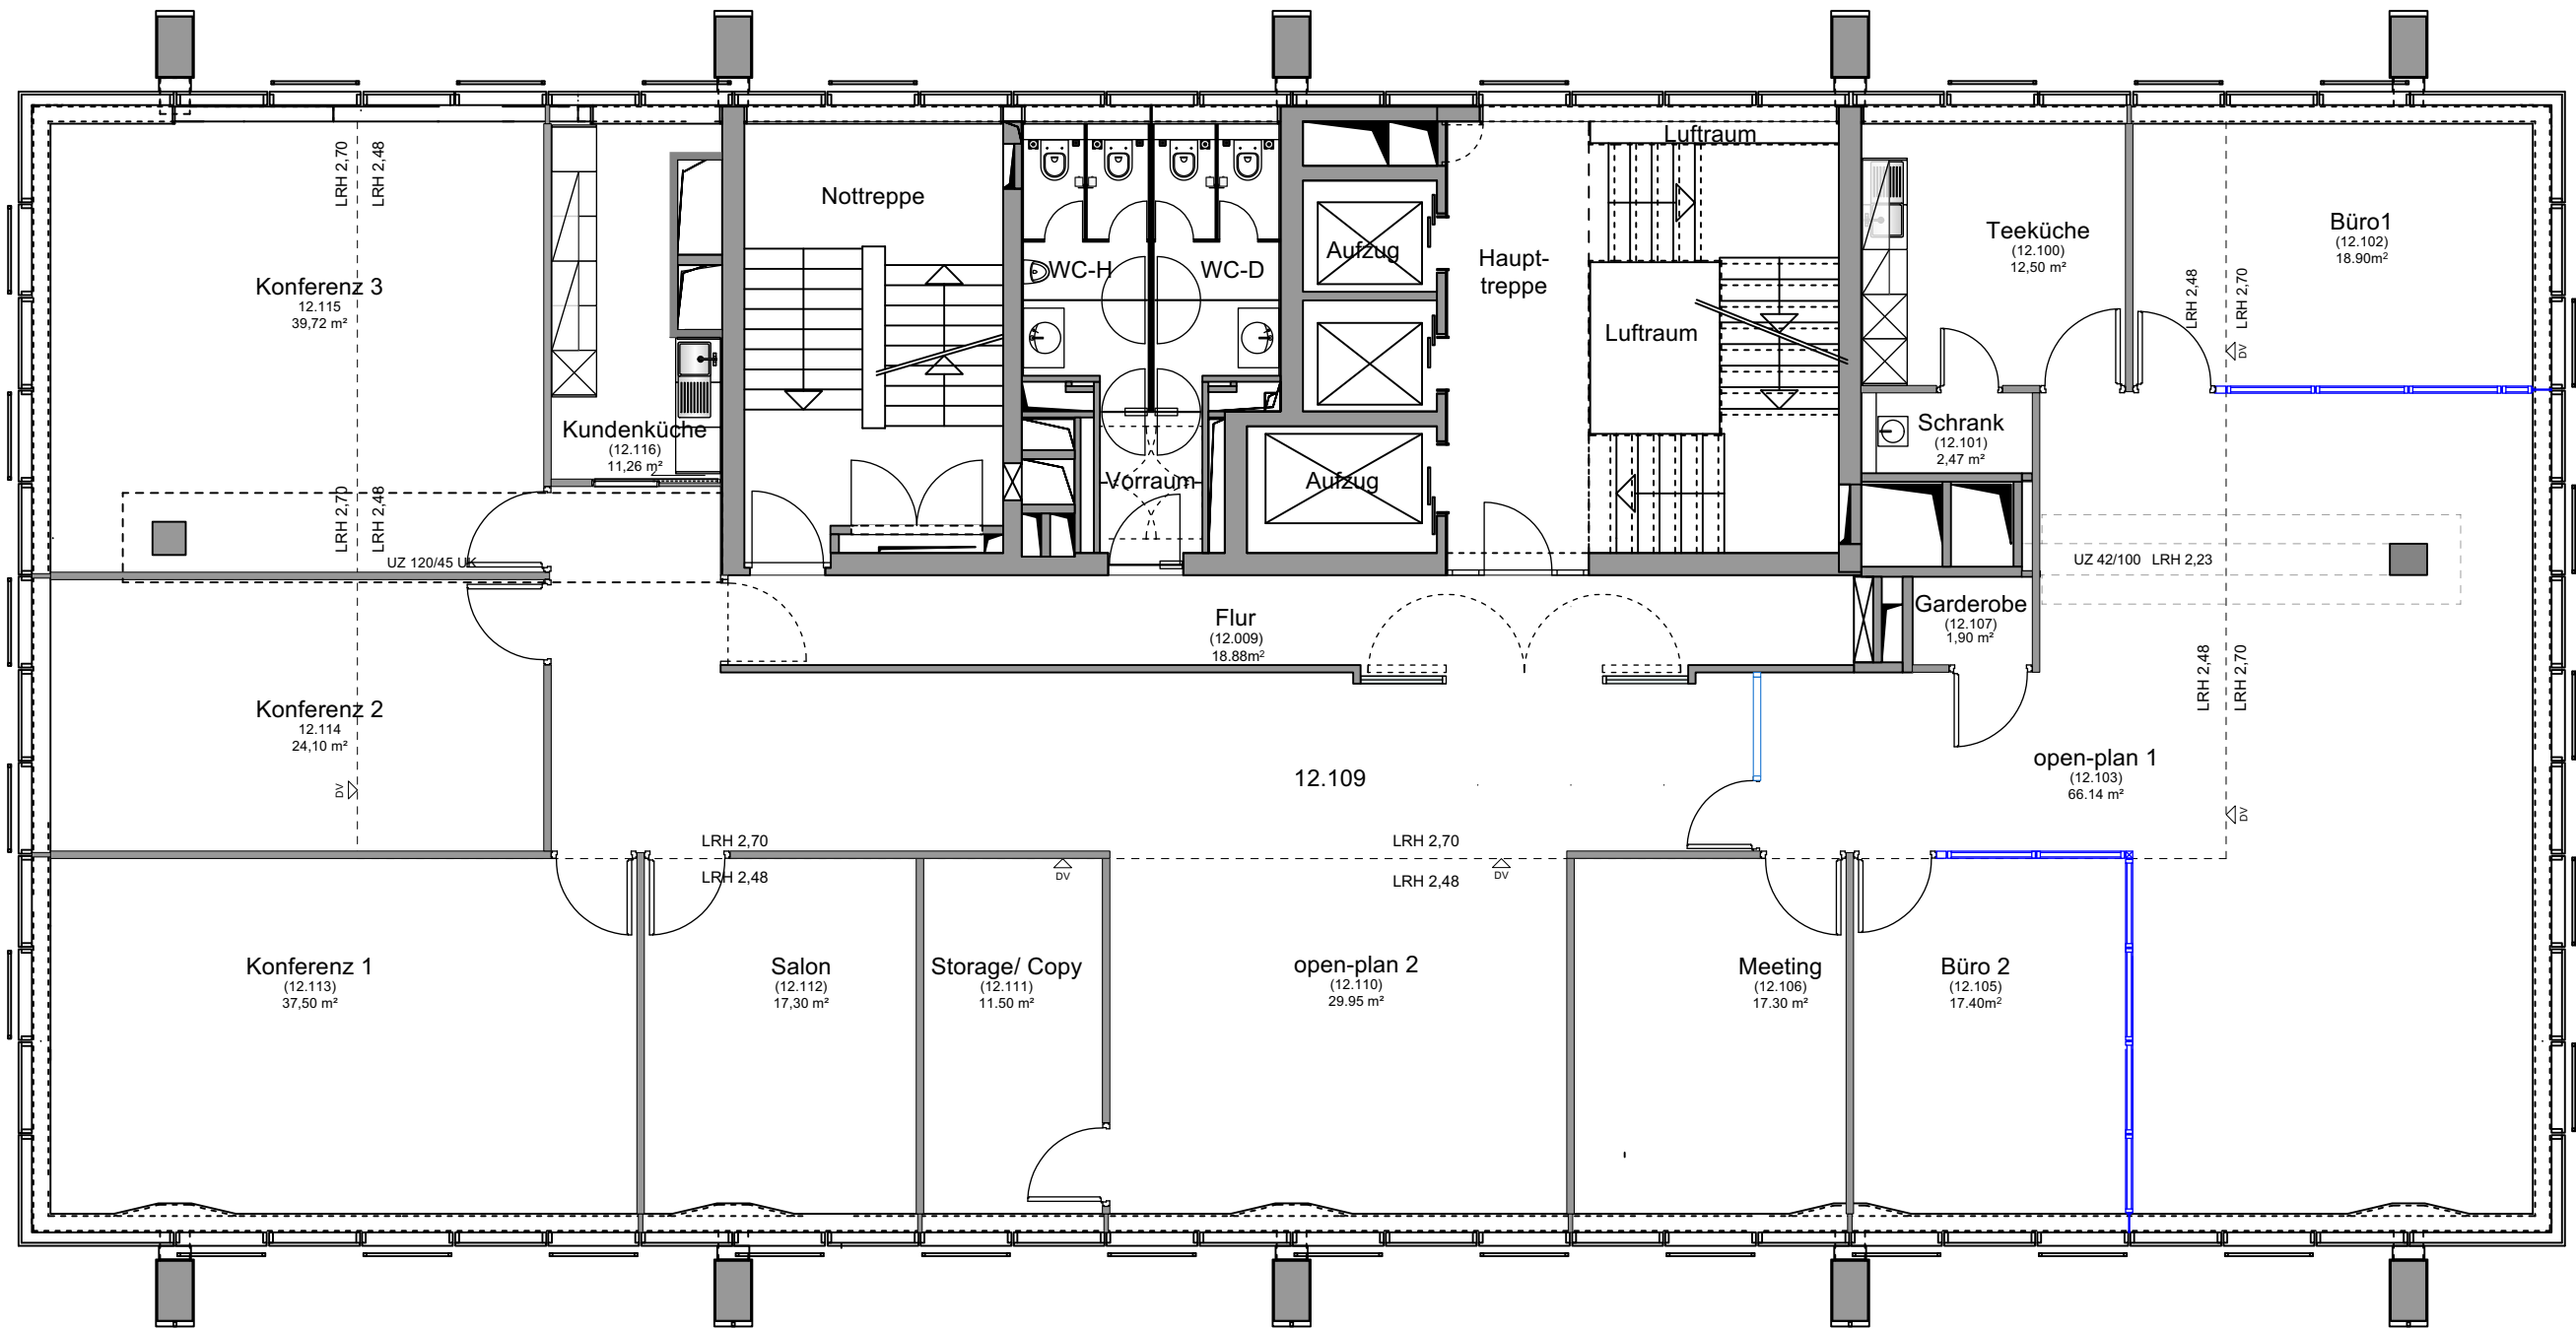

GRUNDRISS 13.OG

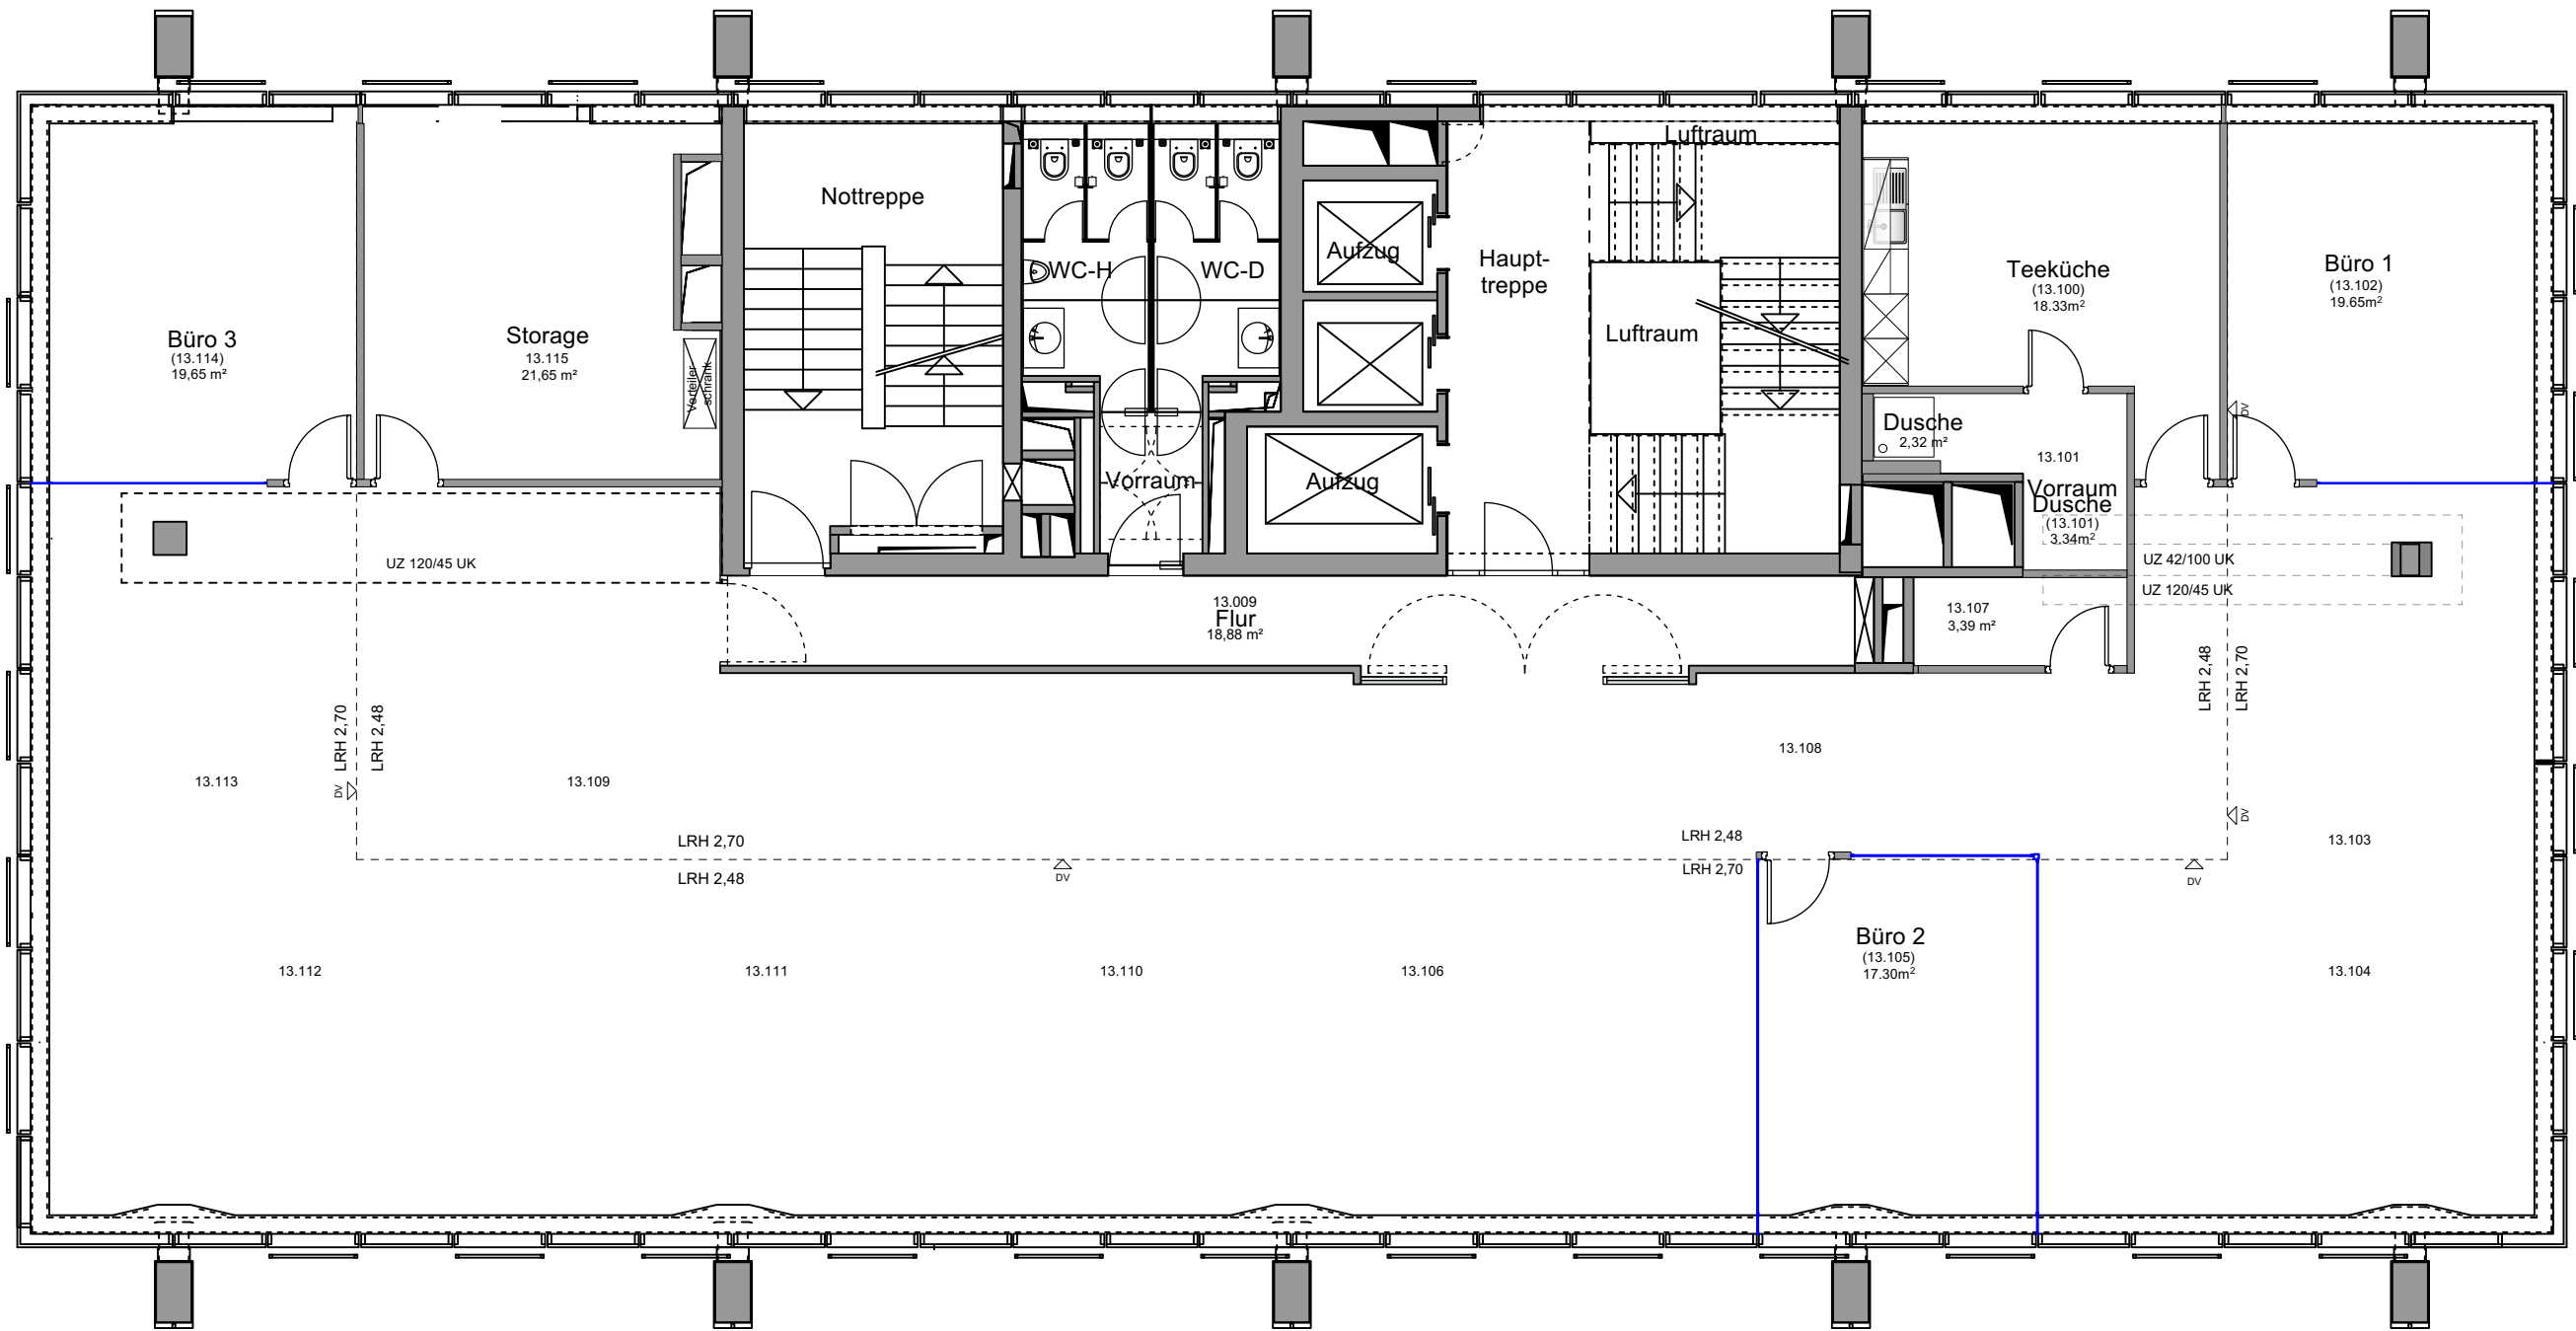

GRUNDRISS 14.OG

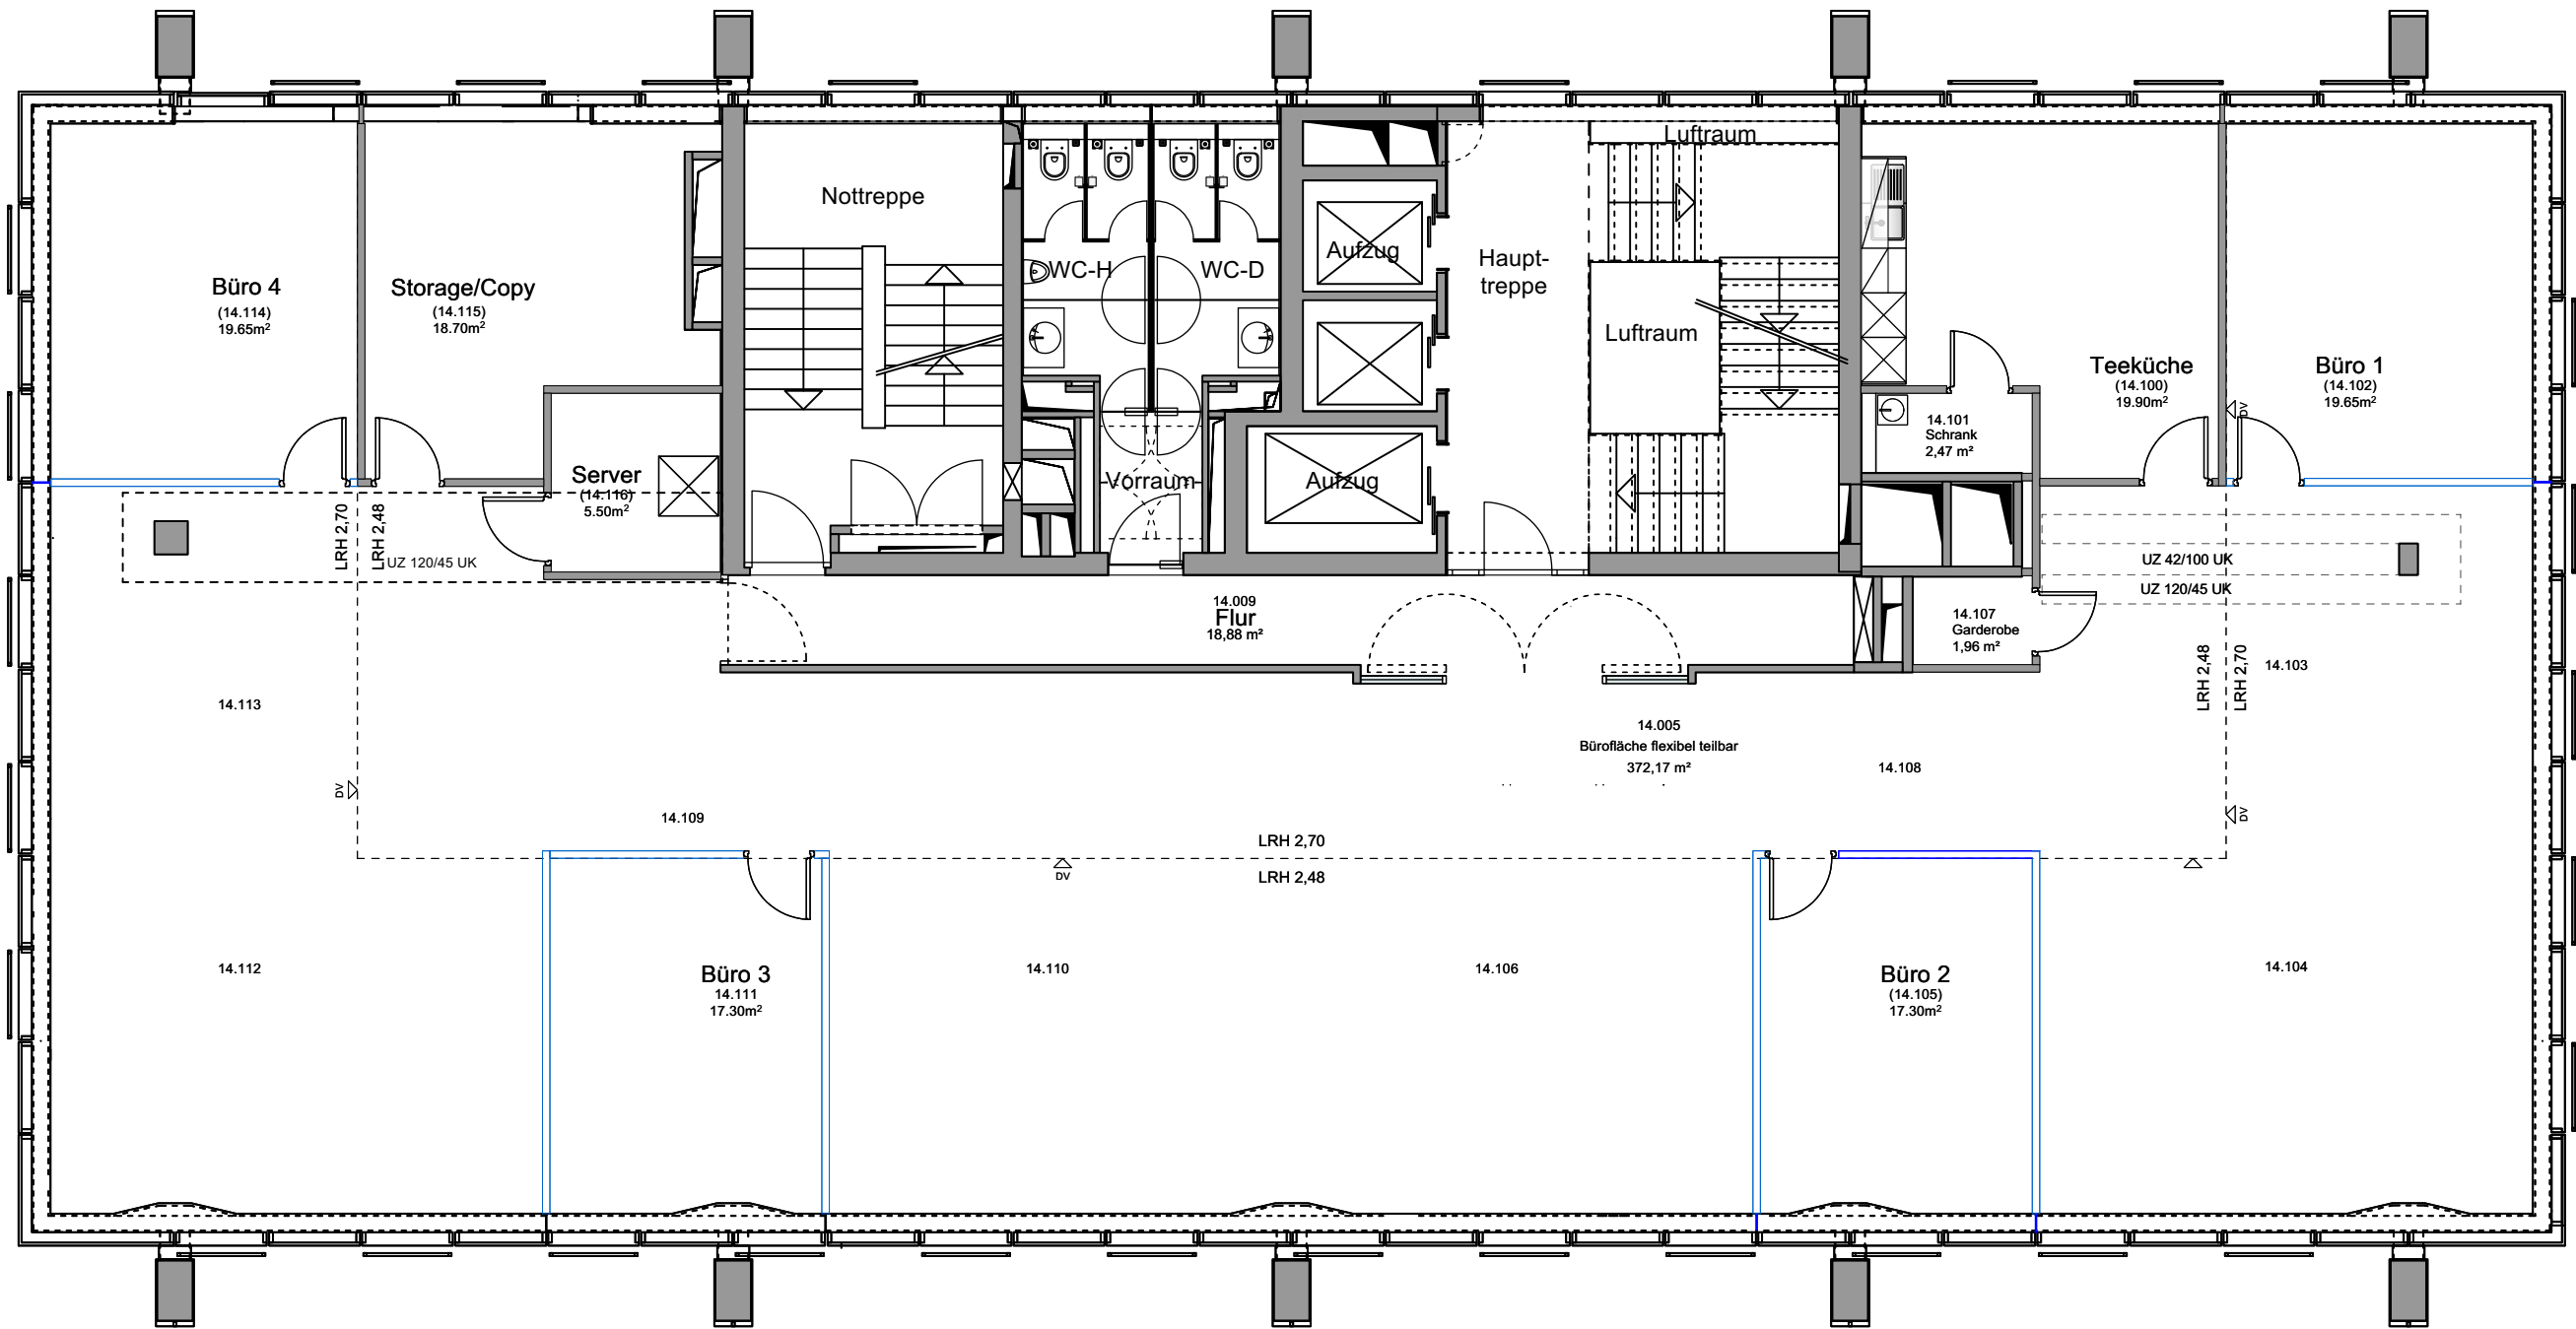

GRUNDRISS 15.OG

